



**Garden  
Spot of  
Colorado**

BERTHOUD PERMIT #

807 Mountain Ave.

Berthoud, CO 80513

(970) 532-2643 | [www.berthoud.org](http://www.berthoud.org)

## WATER/WASTEWATER SERVICE INSTALLATION REPORT


Once complete, please submit this form along with a building permit application to the [Berthoud Permit Portal](#). If you have any questions on this form contact **(970) 532-2643** or email [building@berthoud.org](mailto:building@berthoud.org)

Property Information:		
Address:		
City:	State:	ZIP:
Subdivision:	Lot:	Block:
Parcel #:		
Applicant Information:		
Name/Company:		
Address:		
City:	State:	ZIP:
Connection Information:		
Installation Date:	Larimer County Building Permit # (if applicable):	
WATER AND WASTEWATER SERVICE SKETCH		WASTEWATER PROFILE SKETCH
<b>Sketch Criteria:</b> Show North Arrow, lot lines, piping lengths, piping material types, depths, couplings, fittings, clean-outs, curb stop box or meter pit referenced from two locations, sidewalk with "W" and "S" each location, foundation, ground level, piping slope.		

Installer Certification: (By signing, you are certifying that the sketch is drawn correctly.)

Company Name:	Installer Name:	
Address:	Installer Signature:	
City/State/ZIP:	Phone:	Email:
Builder Certification: (By signing, you are certifying that the Installer has installed the water and sewer services as sketched.)		
Company Name:	Name:	
Address:	Signature:	
City/State/ZIP:	Phone:	Email:

## \*SKETCH SAMPLE\*

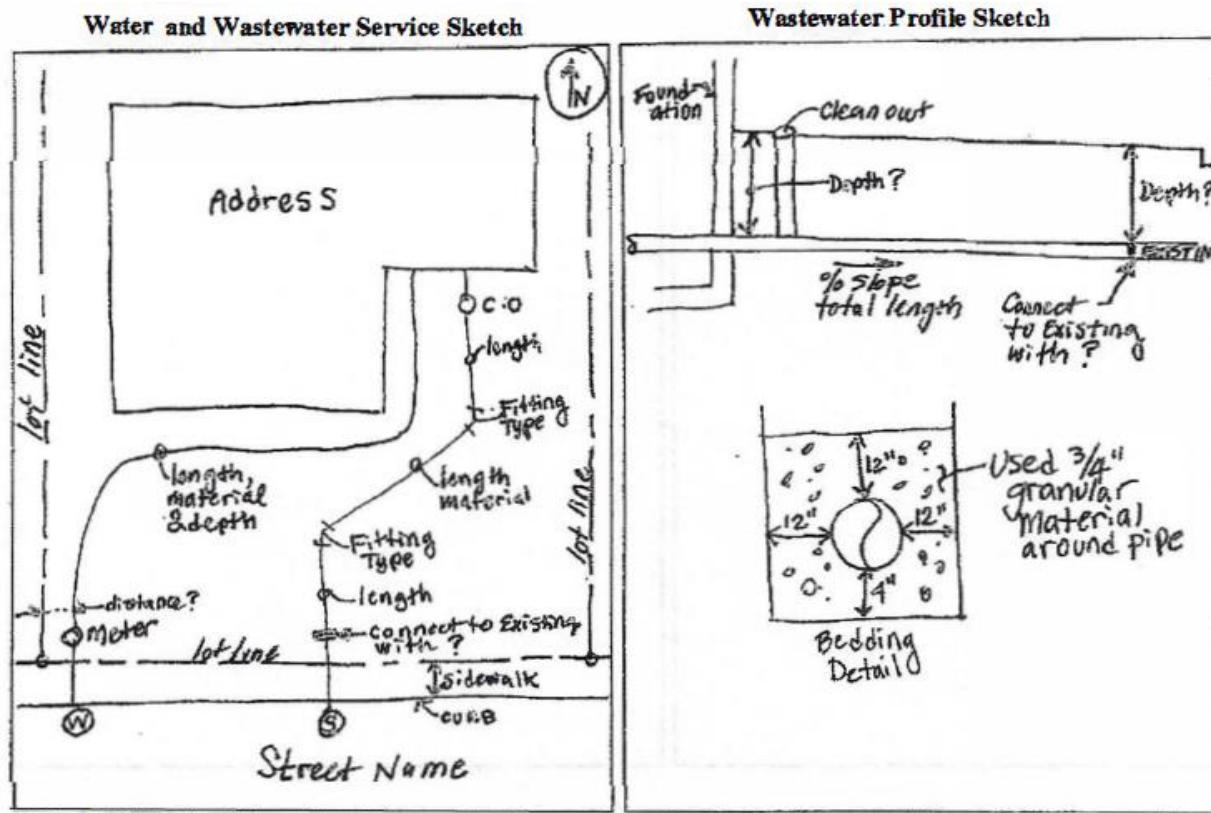

**Sketch Criteria:** Show North Arrow, lot lines, piping lengths, piping material types, depths, couplings, fittings, clean-outs, curb stop box or meter pit referenced from two locations, sidewalk with "W" and "S" each location, foundation, ground level, piping slope.

### STAFF ONLY

DATE:

COMMENTS:

\*LIFT STATION:  BOMAR  CAMPION  RIVER GLEN  HERON LAKES